

- NOTES:
1. HORIZONTAL CONTROL FOR THIS AS-BUILT IS BASED ON PUBLISHED USGS SURVEY MONUMENTS.
 2. THE UTILITIES SHOWN HEREON ARE BASED ON SURFACE LOCATIONS AND CONSTRUCTION FOREMAN.
 3. THE SEWER LINE SHOWN HEREON WAS INSTALLED BY TIDELAND UTILITIES INC. AND INSTALLATION WAS COMPLETED IN MARCH, 2007.

DHEC PERMIT # 33,159-WW

NEW PIPE TABLE	
SIZE / TYPE	LENGTH
6" PVC SERVICE	61 LF
8" PVC MAIN	639 LF
1 EXISTING MANHOLE	
2 NEW MANHOLES	

MANHOLE TABLE

MANHOLE FROM	MANHOLE TO	INVERT IN	INVERT OUT	LENGTH (LF)	PERCENT SLOPE
EXMH	MH 1	-0.54'	0.88'	368	0.39%
MH 1	MH 2	0.91'	1.90'	250	0.40%


THE DIMENSIONS SHOWN ON THE AS-BUILT DRAWINGS WERE OBTAINED USING GOOD SURVEYING PROCEDURES. THE HORIZONTAL DIMENSIONS SHOWN ARE WITHIN THE +/- ONE (1) FOOT TOLERANCE. VERTICAL DIMENSIONS ON GRAVITY WASTEWATER PIPE ARE ACCURATE WITHIN +/- ONE HUNDRETH (0.01) OF A FOOT.

Patrick D. O'Neill 5-8-07
PATRICK D. O'NEILL, S.C.P.L.S. NO. 14800

IT IS MY OPINION THAT THE WATER AND/OR SEWER UTILITIES SERVING THIS PROJECT WERE CONSTRUCTED SUBSTANTIALLY IN ACCORDANCE WITH THE PLANS AND SPECIFICATIONS APPROVED BY THE COMMISSIONERS OF PUBLIC WORKS OF THE TOWN OF MOUNT PLEASANT, SOUTH CAROLINA. IT IS FURTHER MY OPINION THAT THE CONTRACTOR USED ACCEPTABLE CONSTRUCTION PRACTICES. ANY DEVIATIONS BETWEEN THE SYSTEM AS-BUILTS AND THE PLANS AND SPECIFICATIONS WILL NOT IMPACT THE OPERATIONABILITY, CAPACITY, OR CAPABILITY OF THE SYSTEM.

STUART D. WHITESIDE NO. 9437

REV	DATE	REVISION DESCRIPTION

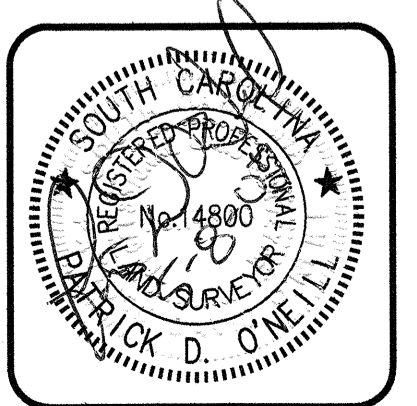

PATRICK D. O'NEILL, RLS
746 SCHAFFER DRIVE - CHARLESTON, SC 29412
843-762-1226

OFFICES at BELLE HALL
MOUNT PLEASANT, SOUTH CAROLINA

SHEET TITLE
SEWER AS-BUILT

JOB NO BH-ASB	
DATE 04-25-07	
DRAWN BY	CHECKED BY
SHEET NUMBER 1 of 1	