


GRID

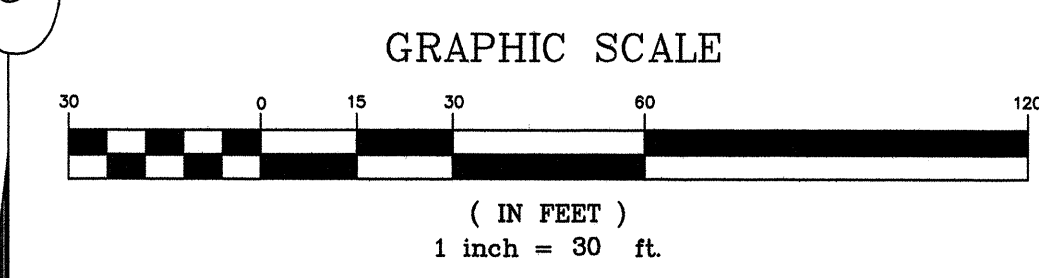

DHEC PERMIT # 23,643-WS

| NEW PIPE TABLE      |          |
|---------------------|----------|
| SIZE                | LENGTH   |
| 1" PE TUBING        | 8 L.F.   |
| 2" PE TUBING        | 10 L.F.  |
| 6" PVC              | 156 L.F. |
| 8" PVC              | 69 L.F.  |
| 12" PVC             | 629 L.F. |
| 2 NEW 12" VALVES    |          |
| 1 NEW 8" VALVES     |          |
| 3 NEW 6" VALVES     |          |
| 2 NEW FIRE HYDRANTS |          |
| 1 NEW 2" VALVES     |          |
| 1 NEW 1" VALVES     |          |

- NOTES:
- HORIZONTAL CONTROL FOR THIS AS-BUILT IS BASED ON PUBLISHED USGS SURVEY MONUMENTS.
  - THE UTILITIES SHOWN HEREON ARE BASED ON SURFACE LOCATIONS AND COMMENTS FROM THE CONSTRUCTION FOREMAN.
  - THE WATER LINE SHOWN HEREON WAS INSTALLED BY TIDELAND UTILITIES INC. AND INSTALLATION WAS COMPLETED IN MARCH, 2007.
  - ALL FIRE HYDRANTS ARE MANUFACTURED BY AMERICAN FLOW CONTROL.
  - ALL WATER VALVES ARE MANUFACTURED BY AMERICAN FLOW CONTROL.


IT IS MY OPINION THAT THE WATER AND/OR SEWER UTILITIES SERVING THIS PROJECT WERE CONSTRUCTED SUBSTANTIALLY IN ACCORDANCE WITH THE PLANS AND SPECIFICATIONS APPROVED BY THE COMMISSIONERS OF PUBLIC WORKS OF THE TOWN OF MOUNT PLEASANT, SOUTH CAROLINA. IT IS FURTHER MY OPINION THAT THE CONTRACTOR USED ACCEPTABLE CONSTRUCTION PRACTICES. ANY DEVIATIONS BETWEEN THE SYSTEM AS-BUILTS AND THE PLANS AND SPECIFICATIONS WILL NOT IMPACT THE OPERATION, CAPACITY, OR CAPABILITY OF THE SYSTEM.

STUART D. WHITESIDE NO. 9437

THE DIMENSIONS SHOWN ON THE AS-BUILT DRAWINGS WERE OBTAINED USING GOOD SURVEYING PROCEDURES. THE HORIZONTAL DIMENSIONS SHOWN ARE WITHIN THE +/- ONE (1) FOOT TOLERANCE. VERTICAL DIMENSIONS ON GRAVITY WASTEWATER PIPE ARE ACCURATE WITHIN +/- ONE HUNDRETH (0.01) OF A FOOT.

*Patrick D. O'Neill*  
PATRICK D. O'NEILL, S.C.P.L.S. NO. 14800

| REV# | DATE | REVISION DESCRIPTION |
|------|------|----------------------|
|      |      |                      |
|      |      |                      |
|      |      |                      |
|      |      |                      |

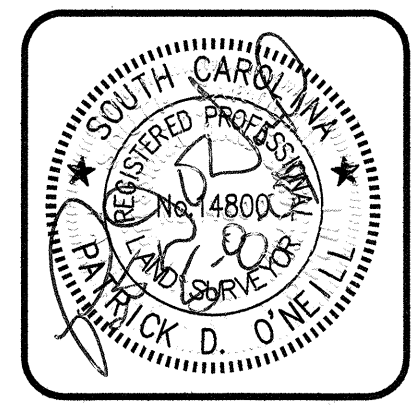

**PATRICK D. O'NEILL, RLS**  
746 SCHAFER DRIVE - CHARLESTON, SC 29412  
843-762-1226

OFFICES at BELLE HALL  
MOUNT PLEASANT, SOUTH CAROLINA

SHEET TITLE  
**WATER AS-BUILT**

|                        |            |
|------------------------|------------|
| JOB NO<br>BH-ASB       |            |
| DATE<br>04-25-07       |            |
| DRAWN BY               | CHECKED BY |
| SHEET NUMBER<br>1 of 1 |            |